

PETITION FOR SPECIAL EXCEPTION

TO THE ZONING COMMISSIONER OF BALTIMORE COUNTY:

The undersigned, legal owner(s) of the property situate in Baltimore County and which is described in the description and plat attached hereto and made a part hereof, hereby petition for a Special Exception under the Zoning Law and Zoning Regulations of Baltimore County. To use the herein described property for one (1) 12' x 25' illuminated sign advertising structure

Property is to be posted and advertised as prescribed by Zoning Regulations.

I agree to pay expenses of above Special Exception advertising, posting, etc., upon filing of this petition, and further agree to and are to be bound by the zoning regulations and restrictions of Baltimore County adopted pursuant to the Zoning Law for Baltimore County.

I hereby solemnly declare and affirm, under the penalties of perjury, that I am the legal owner(s) of the property which is the subject of this Petition.

Contract Lessee: Poster and Kleiser
 (Type or Print Name)
 Signature: [Signature]
 Address: 3001 Remington Avenue
Baltimore, Maryland 21211
 City and State
 Attorney for Petitioner:
 Name: Earl Walker
 (Type or Print Name)
 Address: 7800 Harford Road
Parkville, Maryland 21234
 City and State
 Name and telephone number of person to be contacted: Wilbur R. Walker, Agent
 Name: Wilbur R. Walker, Agent
 State: MD
 Telephone No.: 235-8820

ORDERED By The Zoning Commissioner of Baltimore County, this 10th day of February, 1981, that the subject matter of this petition be advertised, as required by the Zoning Law of Baltimore County, in two newspapers of general circulation throughout Baltimore County, that property be posted, and that the public hearing be had before the Zoning Commissioner of Baltimore County in Room 106, County Office Building in Towson, Baltimore County, on the 9th day of April, 1981, at 10:00 o'clock A.M.

[Signature]
 Zoning Commissioner of Baltimore County.

Z.C.O.-No. 1 (over)

RE: PETITION FOR SPECIAL EXCEPTION : BEFORE THE ZONING COMMISSIONER
 NW/S of Harford Rd., 104' : OF BALTIMORE COUNTY
 NE of Taylor Ave., 9th District
 EARL WALKER, Petitioner : Case No. 81-174-X

ORDER TO ENTER APPEARANCE

Mr. Commissioner:

Pursuant to the authority contained in Section 524.1 of the Baltimore County Charter, I hereby enter my appearance in this proceeding. You are requested to notify me of any hearing date or dates which may be now or hereafter designated therefore, and of the passage of any preliminary or final Order in connection therewith.

Peter Max Zimmerman John W. Hession, III
 Deputy People's Counsel People's Counsel for Baltimore County
 Rm. 223, Court House
 Towson, Maryland 21204
 494-2188

I HEREBY CERTIFY that on this 18th day of March, 1981, a copy of the foregoing Order was mailed to Mr. Earl Walker, 7800 Harford Road, Parkville, Maryland 21234; and Mr. Wilbur R. Walker, Agent, Foster and Kleiser, 3001 Remington Avenue, Baltimore, Maryland 21211, Contract Lessee.

[Signature]
 John W. Hession, III

BALTIMORE COUNTY

ZONING PLANS

ADVISORY COMMITTEE



PETITION AND SITE PLAN

EVALUATION COMMENTS

BALTIMORE COUNTY ZONING PLANS ADVISORY COMMITTEE

March 27, 1981

COUNTY OFFICE BLDG.
 111 W. Chesapeake Ave.
 Towson, Maryland 21204

MEMBERS

Bureau of Engineering
 Department of Traffic Engineering
 State Parks Commission
 Bureau of Fire Prevention
 Health Department
 Project Planning
 Building Department
 Board of Education
 Zoning Administration
 Industrial Development

Mr. Earl Walker
 7800 Harford Road
 Baltimore, Maryland 21234

RE: Item No. 138
 Petitioner - Earl Walker
 Special Exception Petition

Dear Mr. Walker:

The Zoning Plans Advisory Committee has reviewed the plans submitted with the above referenced petition. The following comments are not intended to indicate the appropriateness of the zoning action requested, but to assure that all parties are made aware of plans or problems with regard to the development plans that may have a bearing on this case. The Director of Planning may file a written report with the Zoning Commissioner with recommendations as to the suitability of the requested zoning.

Because of the proposal to locate an outdoor advertising sign on this property, this Special Exception is required. In view of the letter from Mr. W. R. Walker to Mr. Ted Burnham on February 13, 1981, which is included in this file, I have scheduled this petition for a hearing.

Enclosed are all comments submitted to this office from the committee members at this time. The remaining members felt that no comment was warranted. This petition was accepted for filing on the date of the enclosed certificate and a hearing scheduled accordingly.

Very truly yours,

Nicholas B. Commodari
 NICHOLAS B. COMMODARI, Chairman
 Zoning Plans Advisory Committee

NEC:bsc

Enclosures

cc: Wilbur R. Walker, Agent
 Foster and Kleiser
 3001 Remington Avenue
 Baltimore, Md. 21211

ORDER RECEIVED FOR FILING

DATE April 15, 1981

BALTIMORE COUNTY
 DEPARTMENT OF PUBLIC WORKS
 TOWSON, MARYLAND 21204

HARRY J. PISTEL, P.E.
 DIRECTOR

March 5, 1981

Mr. William E. Hammond
 Zoning Commissioner
 County Office Building
 Towson, Maryland 21204

Re: Item #138 (1980-1981)
 Property Owner: Earl Walker
 NW/S Harford Rd. 104' N/E of Taylor Ave.
 Acres: 8 x 25 District: 9th

Dear Mr. Hammond:

The following comments are furnished in regard to the plat submitted to this office for review by the Zoning Advisory Committee in connection with the subject item.

General:

This property comprises Lot 10 of plat "Map of Parkville", recorded J.W.S. 1, Folio 34.

Baltimore County highway and utility improvements are not directly involved.

This office has no further comment in regard to the plan submitted for Zoning Advisory Committee review in connection with this item 138 (1980-1981).

Very truly yours,

[Signature]
 ROBERT A. NORTON, P.E., Chief
 Bureau of Public Services

RAM:EAM:FWR:ss

cc: Jack Wimbley

N-SE Key Sheet
 28 NE 14 Pos. Sheet
 NE 7 E Topo
 81 Tax Map

Maryland Department of Transportation
 State Highway Administration

James J. O'Donnell
 Secretary
 M. S. Caltrider
 Administrator

February 13, 1981

Mr. William Hammond
 Zoning Commissioner
 County Office Bldg.
 Towson, Md. 21204

Attention: Mr. N. Commodari

Re: Z.A.C. Meeting of 2-10-81
 ITEM: #138
 Property Owner: Earl Walker
 Location: NW/S Harford Rd.
 (Route 147) 104' N/E of
 Taylor Ave.
 Existing Zoning: EL
 Proposed Zoning: Special
 Exception for one illuminated
 advertising structure.
 Acres: 8 x 25
 District: 9th

Dear Mr. Hammond:

On review of the site plan and field inspection on February 10, 1981 comments are as follows.

The State Highway Administration finds the proposed location of the poster panel outside the State Right of Way acceptable.

Very truly yours,

Charles Lee, Chief
 Bureau of Engineering
 Access Permits

[Signature]
 By: George Wittman

CL:GW:vrd

BALTIMORE COUNTY
 OFFICE OF PLANNING AND ZONING
 TOWSON, MARYLAND 21204
 494-3211

NORMAN E. GERBER
 DIRECTOR

March 11, 1981

Mr. William Hammond, Zoning Commissioner
 Zoning Advisory Committee
 Office of Planning and Zoning
 Baltimore County Office Building
 Towson, Maryland 21204

Dear Mr. Hammond:

Comments on Item #138, Zoning Advisory Committee Meeting, February 10, 1981, are as follows:

Property Owner: Earl Walker
 Location: NW/S Harford Road 104' N/E of Taylor Avenue
 Acres: 8 x 25
 District: 9th

This office has reviewed the subject petition and offers the following comments. These comments are not intended to indicate the appropriateness of the zoning in question, but are to assure that all parties are made aware of plans or problems with regard to development plans that may have a bearing on this petition.

This petition meets the requirements of the Division of Current Planning and Development.

Very truly yours,

[Signature]
 John L. Wimbley
 Planner III
 Current Planning and Development

Baltimore County
 Department of Traffic Engineering
 TOWSON, MARYLAND 21204
 (301) 494-3550

STEPHEN E. COLLINS
 DIRECTOR

March 16, 1981

Mr. William Hammond
 Zoning Commissioner
 County Office Building
 Towson, Maryland 21204

Dear Mr. Hammond:

With regard to ZAC meeting of February 10, 1981,

this Department has no comment on items #137 thru 141 as well as item #143 and #144.

Very truly yours,

[Signature]
 Michael S. Flanigan
 Engineer Associate II

NEP/bza

138

My telephone number is (301) 659-1350

P.O. Box 717 1707 North Calvert St., Baltimore, Maryland 21203

Pursuant to the advertisement, posting of property, and public hearing on the Petition and it appearing that by reason of the requirements of Section 502.1 of the Baltimore County Zoning Regulations having been met and the health, safety, and general welfare of the community not being adversely affected, the special exception should be granted.

Therefore, IT IS ORDERED by the Deputy Zoning Commissioner of Baltimore County, this 15th day of April, 1981, that the herein Petition for Special Exception for the erection of one 12' x 25' illuminated outdoor advertising structure should be and the same is GRANTED, from and after the date of this

Order, subject, however, to the following restrictions:

1. Compliance with Sections 413.3 and 413.5 of the aforementioned regulations.
2. Approval of a site plan by the Maryland Department of Transportation, the Department of Public Works and the Office of Planning and Zoning.

John M. H. Jung
Deputy Zoning Commissioner of Baltimore County

BALTIMORE COUNTY
DEPARTMENT OF HEALTH
TOWSON, MARYLAND 21204
DONALD J. ROOP, M.D., M.P.H.
DEPUTY STATE & COUNTY HEALTH OFFICER

March 11, 1981

Mr. William E. Hammond, Zoning Commissioner
Office of Planning and Zoning
County Office Building
Towson, Maryland 21204

Dear Mr. Hammond:

Comments on Items 138, Zoning Advisory Committee Meeting of February 10, 1981, are as follows:

Property Owner: Earl Walker
Location: NW/3 Harford Road 104' N/E of Taylor Avenue
Existing Zoning: BL
Proposed Zoning: Special Exception for one illuminated advertising structure.
Acres: 8X25
District: 9th

The proposed advertising structure should not present any health hazards.

Very truly yours,

Ian V. Forrest
Ian V. Forrest, Director
BUREAU OF ENVIRONMENTAL SERVICES

LJF/ko

BALTIMORE COUNTY
FIRE DEPARTMENT
TOWSON, MARYLAND 21204
625-7310

PAUL H. REINCKE
CHIEF

March 6, 1981

Mr. William Hammond
Zoning Commissioner
Office of Planning and Zoning
Baltimore County Office Building
Towson, Maryland 21204

Attention: Nick Commodari, Chairman
Zoning Plans Advisory Committee

Re: Property Owner: Earl Walker

Location: NW/3 Harford Road 104' N/E of Taylor Avenue

Item No.: 138 Zoning Agenda: Meeting of Feb. 10, 1981

Gentlemen:

Pursuant to your request, the referenced property has been surveyed by this Bureau and the comments below marked with an "X" are applicable and required to be corrected or incorporated into the final plans for the property.

- () 1. Fire hydrants for the referenced property are required and shall be located at intervals of 100 feet along an approved road in accordance with Baltimore County Standards as published by the Department of Public Works.
- () 2. A second means of vehicle access is required for the site.
- () 3. The vehicle dead end condition shown at _____ EXCEEDS the maximum allowed by the Fire Department.
- () 4. The site shall be made to comply with all applicable parts of the Fire Prevention Code prior to occupancy or beginning of operation.
- () 5. The buildings and structures existing or proposed on the site shall comply with all applicable requirements of the National Fire Protection Association Standard No. 101 "Life Safety Code", 1976 Edition prior to occupancy.
- () 6. Site plans are approved, as drawn.
- (X) 7. The Fire Prevention Bureau has no comments, at this time.

REVIEWED BY: *Earl Walker* Noted and Approved: *George M. Haranoff*
Planning Group Fire Prevention Bureau
Special Inspection Division

/mb

BALTIMORE COUNTY, MARYLAND

INTER-OFFICE CORRESPONDENCE

TO: Nick Commodari Date: February 20, 1981
FROM: Charles E. (Ted) Burnham
Zoning Advisory Committee
SUBJECT: Meeting February 10, 1981

ITEM NO. 137 See Comments
ITEM NO. 138 ✓ This item has been discussed 2-12-81 with Mr. Walker and a letter shall be forth coming resolving the problem.
ITEM NO. 139 See Comments
ITEM NO. 140 Standard Comments
ITEM NO. 141 See Comments
ITEM NO. 142 See Comments
ITEM NO. 143 See Comments
ITEM NO. 144 Standard Comments

Charles E. Burnham
Charles E. (Ted) Burnham
Plans Review Supervisor

CEB:rrj

FOSTER AND KLEISER

A METROMEDIA COMPANY
3001 REMINGTON AVENUE
BALTIMORE, MARYLAND 21204
(301) 775-8620

February 13, 1981

Mr. C. E. Burnham
Building Plans Reviewer
Baltimore County
111 W. Chesapeake Ave.
Towson, Md. 21204

Dear Mr. Burnham:

In accord with our conversation on February 12th, concerning our application for permit to erect a sign on premises "NW Harford Road & Taylor Avenue," enclosed please find a sketch.

As you requested, we will be glad to place a steel post at the corner of the adjoining building on the cement parking barrier and connect a chain from the post to the supporting beams of our sign.

We are interested in our application being processed without delay and we trust that this resolves the matter to your satisfaction.


Sincerely,
W. R. Walker
W. R. Walker
Real Estate Devel. Mgr.

Enclosure

WJ/dln

ITEM # 138

OK - *Charles E. Burnham* 2-18-81
Copy to Zoning Commissioner
AND
Nick Commodari.

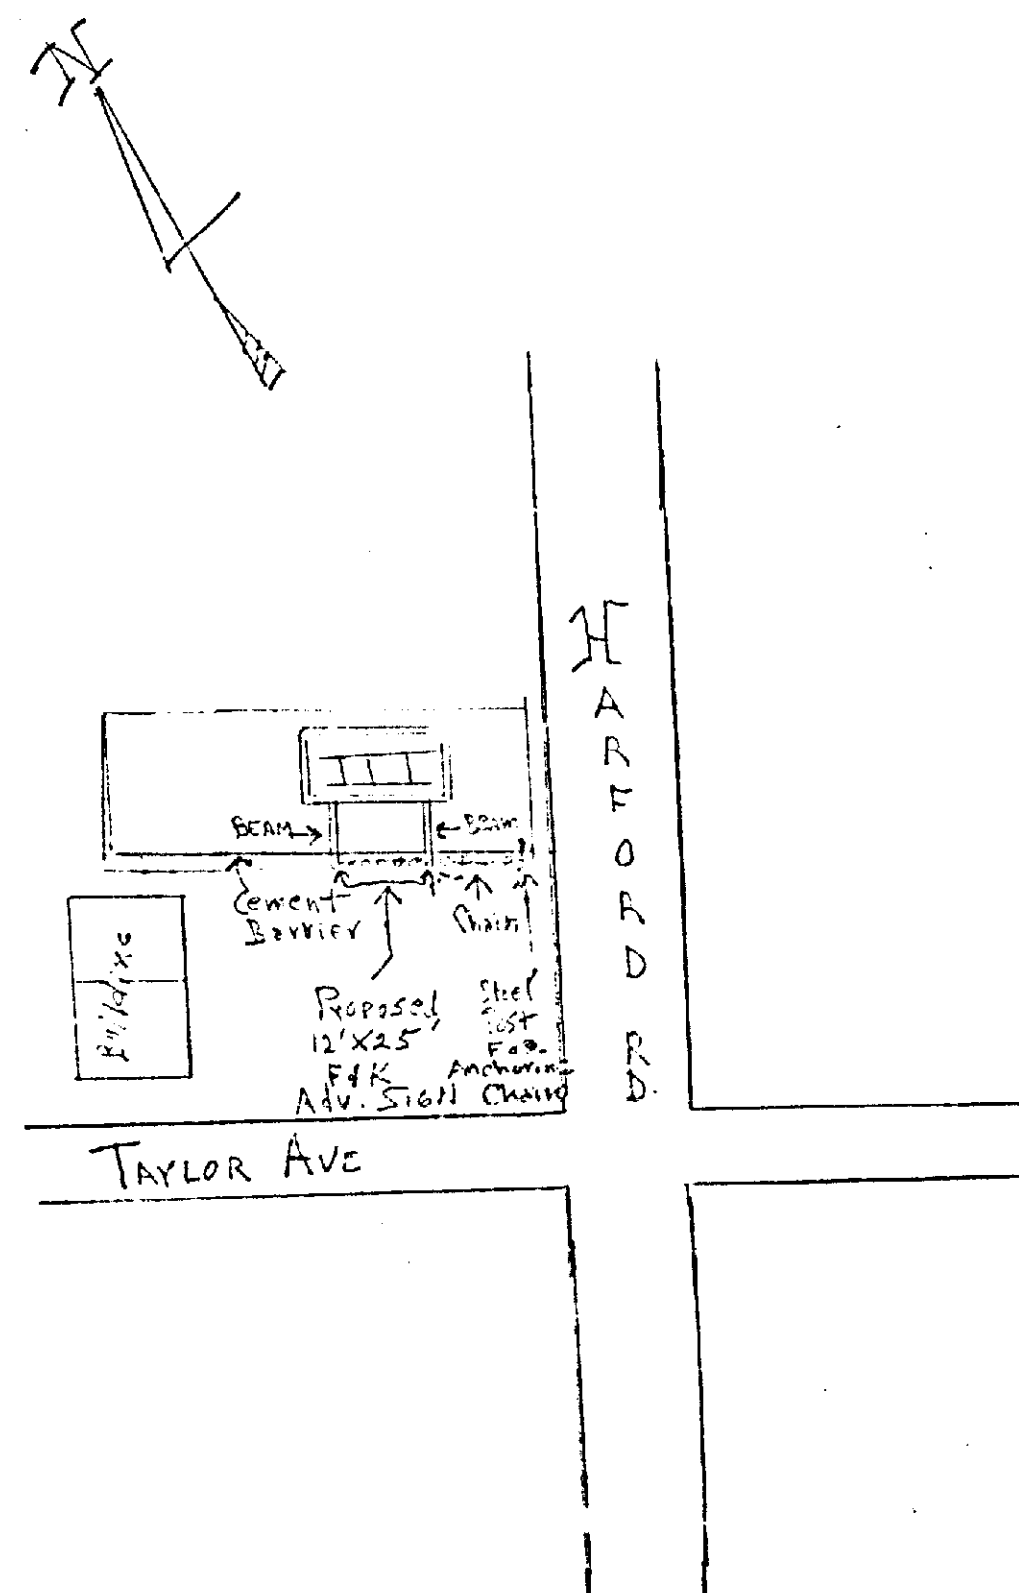

Re Sketch: "No Scale"
Foster and Kleiser
3001 Remington Ave.
Baltimore, Md. 21211
4/13/81

BALTIMORE COUNTY PUBLIC SCHOOLS

Robert Y. Dubel, Superintendent

Towson, Maryland - 21204

Date: February 9, 1981

Mr. William E. Hammond
Zoning Commissioner
Baltimore County Office Building
1111 West Chesapeake Avenue
Towson, Maryland 21204

Z.A.C. Meeting of: February 10, 1981

RE: Item No: 137, 138, 139, 140, 141, 142, 143, 144
Property Owner:
Location:
Present Zoning:
Proposed Zoning:

District:
No. Acres:

Dear Mr. Hammond:

All of the above have no bearing on student population.

Very truly yours,

Jim Nick Petrovich
Jim. Nick Petrovich, Assistant
Department of Planning

KNP/bp

PROPERTY DESCRIPTION

BEGINNING AT A POINT LOCATED ON THE WEST SIDE OF HARFORD ROAD (66 FEET WIDE), 53 FEET FROM THE CENTERLINE AND 104 FEET FROM THE CENTERLINE OF TAYLOR AVENUE (36 FEET WIDE) THENCE RUNNING THE FOLLOWING COURSES AND DISTANCES: 1) NORTHEASTERLY A DISTANCE OF 8 FEET TO A POINT, THENCE 2) NORTHWESTERLY A DISTANCE OF 25 FEET TO A POINT, THENCE 3) SOUTHWESTERLY A DISTANCE OF 8 FEET TO A POINT, THENCE 4) SOUTHEASTERLY A DISTANCE OF 25 FEET TO THE BEGINNING POINT.
PROPERTY KNOWN AS 7800 HARFORD ROAD.

Mr. Earl Walker
7800 Harford Road
Parkville, Maryland 21234

March 9, 1981

NOTICE OF HEARING

RE: Petition for Special Exception - NW/S Harford Road,
104' NE of Taylor Avenue - Case No. 81-174-X

TIME: 10:00 A.M.

DATE: Thursday, April 9, 1981

PLACE: ROOM 106 COUNTY OFFICE BUILDING, 111 W. CHESAPEAKE AVENUE,

TOWSON, MARYLAND

William E. Hammond
ZONING COMMISSIONER OF
BALTIMORE COUNTY

cc: Mr. Wilbur R. Walker
Foster & Kleiser
3001 Remington Avenue
Baltimore, Maryland 21211

PETITION FOR SPECIAL EXCEPTION

9th District

ZONING: Petition for Special Exception
LOCATION: Northwest side of Harford Road, 104 feet Northeast of
Taylor Avenue
DATE & TIME: Thursday, April 9, 1981 at 10:00 A.M.
PUBLIC HEARING: Room 106, County Office Building, 111 W. Chesapeake Avenue,
Towson, Maryland

The Zoning Commissioner of Baltimore County, by authority of the Zoning Act
and Regulations of Baltimore County, will hold a public hearing:

Petition for Special Exception for one
12' x 25' illuminated outdoor advertising
structure

All that parcel of land in the Ninth District of Baltimore County

Being the property of Earl Walker, as shown on plat plan filed with the
Zoning Department

Hearing Date: Thursday, April 9, 1981 at 10:00 A.M.
Public Hearing: Room 106, County Office Building, 111 W. Chesapeake Avenue,
Towson, Maryland

BY ORDER OF
WILLIAM E. HAMMOND
ZONING COMMISSIONER
OF BALTIMORE COUNTY

BALTIMORE COUNTY, MARYLAND

INTER-OFFICE CORRESPONDENCE

Mr. W. E. Hammond
Zoning Commissioner
TO: Norman E. Gerber, Director
Office of Planning and Zoning
FROM: Petition No. 81-174-X Item 138
SUBJECT: Petition No. 81-174-X Item 138

Date: March 17, 1981

Petition for Special Exception
Northwest side of Harford Road, 104 feet Northeast of Taylor Avenue
Petitioner: Earl Walker


Ninth District

HEARING: Thursday, April 9, 1981 (10:00 A.M.)

There are no comprehensive planning factors requiring comment on this
petition. If feasible, however, it is suggested consideration be given
to a reduction in the size of the sign.

Norman E. Gerber
Norman E. Gerber, Director
Office of Planning and Zoning

NEG:JGH:db

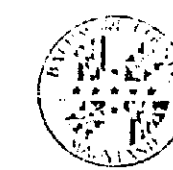

BALTIMORE COUNTY
OFFICE OF PLANNING & ZONING
TOWSON, MARYLAND 21204
494-3353

WILLIAM E. HAMMOND
ZONING COMMISSIONER

April 15, 1981

Ira C. Cooke, Esquire
Sixth Floor
36 South Charles Street
Baltimore, Maryland 21201

RE: Petition for Special Exception
NW/S of Harford Rd., 104' NE of
Taylor Ave. - 9th Election District
Earl Walker - Petitioner
NO. 81-174-X (Item No. 138)

Dear Mr. Cooke:

I have this date passed my Order in the above captioned matter in accord-
ance with the attached.

Very truly yours,

Jean M. H. Jung
JEAN M. H. JUNG
Deputy Zoning Commissioner

JMHJ/mc

Attachments

cc: Mr. Earl Walker
7800 Harford Road
Parkville, Maryland 21234

Mr. Earl Walker
7800 Harford Road
Baltimore, Maryland 21234

Foster & Kleiser
3001 Remington Avenue
Baltimore, Maryland 21211

BALTIMORE COUNTY OFFICE OF PLANNING & ZONING

County Office Building
111 W. Chesapeake Avenue
Towson, Maryland 21204

Your Petition has been received and accepted for filing this 10th day
of February, 1981.

William E. Hammond
WILLIAM E. HAMMOND
Zoning Commissioner

Petitioner: Earl Walker

Petitioner's Attorney: Reviewed by: *Nicholas B. Commodari*
Nicholas B. Commodari
Chairman, Zoning Plans
Advisory Committee

CERTIFICATE OF PUBLICATION

TOWSON, MD., March 19, 1981

THIS IS TO CERTIFY, that the annexed advertisement was
published in THE JEFFERSONIAN, a weekly newspaper printed
and published in Towson, Baltimore County, Md., on the 19th day of
February, 1981, at 10:00 A.M., the day of the publication
appearing on the 19th day of March, 1981.

THE JEFFERSONIAN
David L. Smith
Manager

Cost of Advertisement, \$.

PETITION FOR SPECIAL
EXCEPTION
9th DISTRICT

ZONING: Petition for Special Ex-
ception
LOCATION: Northwest side of Har-
ford Road, 104 feet Northeast of
Taylor Avenue
DATE & TIME: Thursday, April 9,
1981 at 10:00 A.M.
PUBLIC HEARING: Room 106,
County Office Building, 111 W.
Chesapeake Avenue, Towson, Maryland

The Zoning Commissioner of Bal-
timore County, by authority of the
Zoning Act and Regulations of
Baltimore County, will hold a pub-
lic hearing:
Petition for Special Exception for
one 12' x 25' illuminated outdoor
advertising structure.
All that parcel of land in the
Ninth District of Baltimore County
Beginning at a point located on
the west side of Harford Road (66
feet wide), 53 feet from the center-
line and 104 feet from the centerline
of Taylor Avenue (36 feet wide),
thence 1/4 mile (1/4 mile) Northwesterly
a distance of 1/4 mile to a point,
thence 1/4 mile Northwesterly a distance
of 25 feet to a point, thence 1/4 mile
Southwesterly a distance of 25 feet to
a point, thence 1/4 mile Southwesterly
a distance of 25 feet to the beginning
point.
Property known as 7800 Harford
Road.
Being the property of Earl Walker,
as shown on plat plan filed with
the Zoning Department.
Hearing Date: Thursday, April 9,
1981 at 10:00 A.M.
Public Hearing: Room 106, County
Office Building, 111 W. Chesa-
peake Avenue, Towson, Maryland.
By Order Of
WILLIAM E. HAMMOND,
Zoning Commissioner of
Baltimore County
March 19.

CERTIFICATE OF POSTING
ZONING DEPARTMENT OF BALTIMORE COUNTY
Towson, Maryland

District: 9
Posted for: Petition for Special Exception
Petitioner: Earl Walker
Location of property: Northwest side of Harford Rd., 104 feet NE of
Taylor Ave.
Location of Signs: 12' x 25' illuminated outdoor advertising structure
Remarks: See attached plat plan
Posted by: *Earl Walker* Signature Date of return: _____
Number of Signs: 1

Petition For
Special Exception
9th District

Zoning: Petition for Special Ex-
ception
Location: Northwest side
of Harford Road, 104 feet
Northeast of Taylor
Avenue
Date & Time: Thursday,
April 9, 1981 at 10:00 A.M.
Public Hearing: Room
106, County Office
Building, 111 W.
Chesapeake Avenue,
Towson, Maryland.
The Zoning
Commissioner of Baltimore
County, by authority of the
Zoning Act and
Regulations of Baltimore
County, will hold a public
hearing:
Petition for Special
Exception for one 12' x 25'
illuminated outdoor
advertising structure.
All that parcel of land in
the Ninth District of
Baltimore County
Beginning at a point
located on the west side of
Harford Road (66 feet
wide), 53 feet from the
centerline and 104 feet
from the centerline of
Taylor Avenue (36 feet
wide), thence 1/4 mile
Northwesterly a distance
of 1/4 mile to a point,
thence 1/4 mile Northwesterly
a distance of 25 feet to a point,
thence 1/4 mile Southwesterly
a distance of 25 feet to a point,
thence 1/4 mile Southwesterly
a distance of 25 feet to the
beginning point.
Property known as 7800
Harford Road.
Being the property of
Earl Walker, as shown on
plat plan filed with the
Zoning Department.
Hearing Date:
Thursday, April 9, 1981
at 10:00 A.M.
Public Hearing: Room
106, County Office
Building, 111 W.
Chesapeake Avenue,
Towson, Maryland.
BY ORDER OF
William E. Hammond
Zoning Commissioner
of Baltimore County

The Essex Times

Essex, Md., March 19, 1981

This is to Certify, That the annexed

was inserted in The Essex Times, a newspaper
printed and published in Baltimore County, once in
each of one successive
weeks before the 19th day of
March, 1981.
David L. Smith Publisher.

PETITION MAPPING PROGRESS SHEET

FUNCTION	Wall Map		Original		Duplicate		Tracing		200 Sheet	
	date	by	date	by	date	by	date	by	date	by
Descriptions checked and outline plotted on map										
Petition number added to outline										
Denied										
Granted by ZC, BA, CC, CA										
Reviewed by: 01										
Previous case: none										

Revised Plans:
Change in outline or description Yes
No
Map #

BALTIMORE COUNTY OFFICE OF PLANNING & ZONING

County Office Building
111 W. Chesapeake Avenue
Towson, Maryland 21204

Your Petition has been received this 20th day of February, 1981
Filing Fee \$ 5.00 Received: Check
Cash
Other

Item # 138

Petitioner: *Earl Walker* Submitted by: *Earl Walker*
Petitioner's Attorney: Reviewed by: *William E. Hammond*

*This is not to be interpreted as acceptance of the Petition for assignment of a
hearing date.

No. 097222

BALTIMORE COUNTY, MARYLAND
BRIDGE OF FINANCE REVENUE DIVISION
MISCELLANEOUS CASH RECEIPT

DATE: 1/2/81 ACCOUNT: 01-667 AMOUNT: \$17.63

RECEIVED: Foster & Kleiser FOR: Posting and Advertising Case No. 81-174-X

DATE: 1/2/81 ACCOUNT: 01-667 AMOUNT: \$17.63

VALIDATION OF SIGNATURE OF CARRIER

No. 095187

BALTIMORE COUNTY, MARYLAND
OFFICE OF FINANCE REVENUE DIVISION
MISCELLANEOUS CASH RECEIPT

DATE: March 9, 1981 ACCOUNT: 01-662 AMOUNT: \$50.00

RECEIVED: Foster & Kleiser FOR: Filing Fee for Case No. 81-174-X



DATE: 3/9/81 ACCOUNT: 01-662 AMOUNT: \$50.00

VALIDATION OF SIGNATURE OF CARRIER

ZONING - B.L.
SCALE - 1" = 50'
ELECTION DISTRICT -

PROPOSED - ONE 12'x25' ILLUMINATED POSTER PANEL
OWNER - EARL WALKER
7800 HARFORD RD.

NOTE - NO OTHER OUTDOOR ADVERTISING SIGNS
LOCATED WITHIN 100' (SECT. 413.9 f.)
• SIGN WILL BE ERECTED IN ACCORDANCE
WITH SECTION 413 - EALTO. CO. ZONING REGS.
PARK AVE.

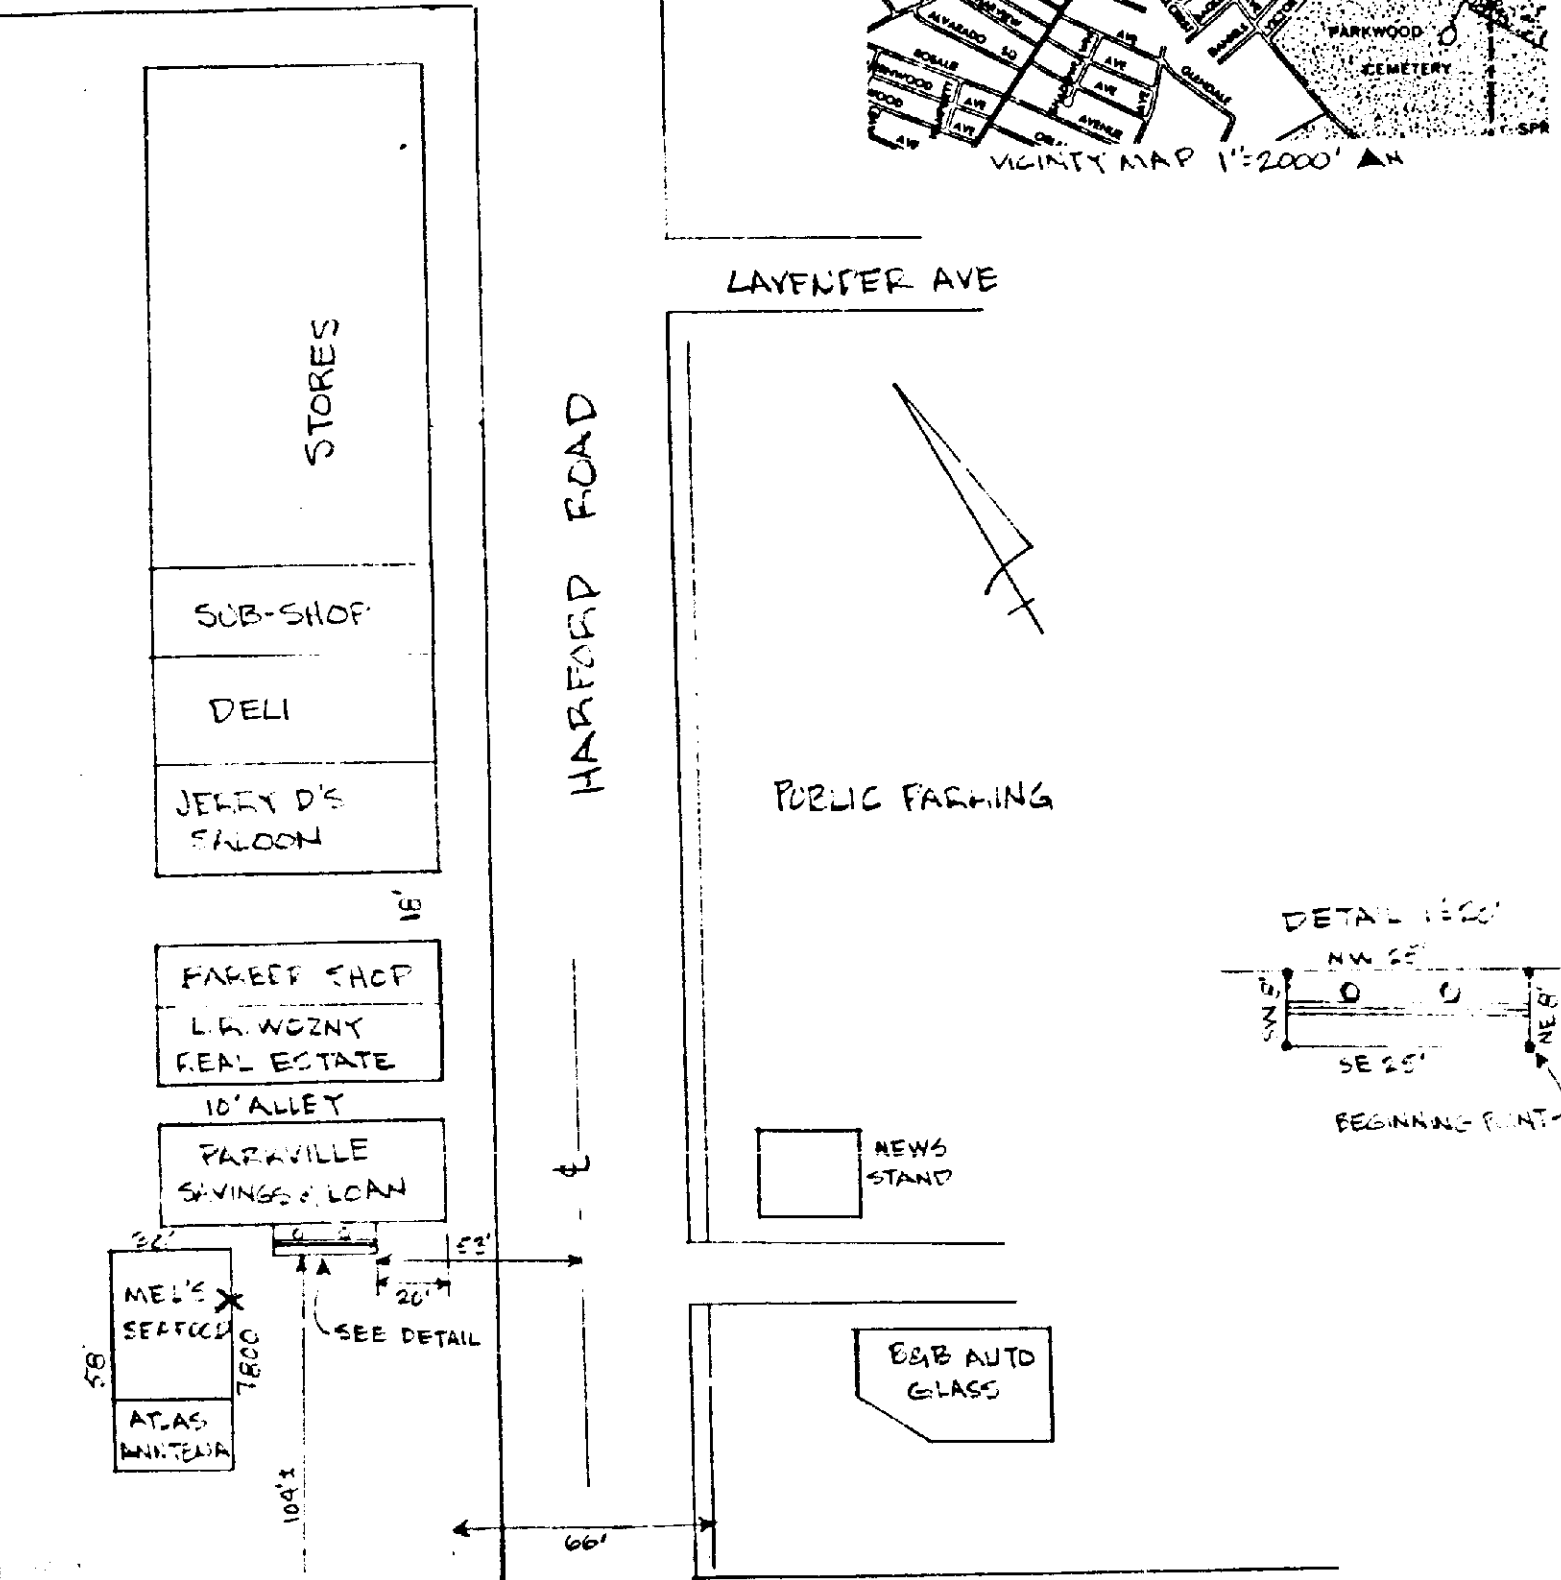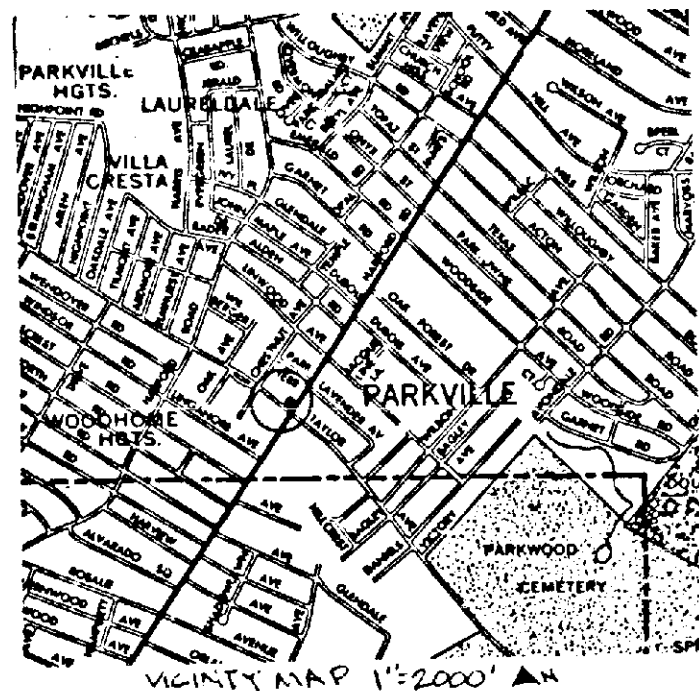

TAYLOR AVE.

SPECIAL EXCEPTION

7800 HARFORD ROAD

FOSTER & KIESER LEASE #1150

